

LEGEND

8.8 — AS CONSTRUCTED CONTOURS (Interval 0.2m)

— RETAINING WALL

I, Peter Sippel, being a cadastral surveyor and duly authorised representative of Queensland Surveying Pty Ltd hereby:

- certify the information contained in this drawing is an accurate as constructed representation of the works
- accept responsibility for the as constructed information contained in this drawing
- acknowledge the as constructed information contained in the drawing may be relied on by council and others

Certification by *P. Sippel* on 16/11/2017
(Signature) (Date)
for Queensland Surveying Pty Ltd

ENGINEER'S CERTIFICATION

I, DARRYL HAYTER, being a Consulting Engineer and duly authorised representative of: — EMPOWER ENGINEERS AND PROJECT MANAGERS, hereby:

- certify the information contained in this drawing is an accurate "as constructed" representation of the works;
- accept responsibility for the "as constructed" information contained in this drawing; and
- acknowledge the "as constructed" information contained in the drawing may be relied on by the Moreton Bay Regional Council and others.

Certification for Stage 19 by *D. Hayter* on 24/11/17
For: EMPOWER ENGINEERS AND PROJECT MANAGERS RPEQ 5694

DRAWING REVISIONS		REFERENCE DRAWINGS		DESIGN FILE No.	DESIGNED
REV.	REVISION DESCRIPTION	DRG. No.	DESCRIPTION	CONSTRUCT. No.	DATE
A	Progress Plot			SURVEY FILE No. 30105-190100 AE	EJM
B	Update			FIELD BOOK	DATE 10/11/2017
				LOG BOOK	CHECKED EJM
				LEVEL DATUM	DATE 10/11/2017
				DATUM	PM177891

THIS WORK WAS PREPARED BY:
QUEENSLAND SURVEYING PTY LTD

SCALE 1:500 ORIGINAL SIZE A1

MORETON BAY REGIONAL COUNCIL
CABOOLTURE DISTRICT OFFICE
2 HASKING STREET CABOOLTURE QLD 4510
PO BOX 159 CABOOLTURE QLD 4510
Telephone: (07) 5433 0100
Fax: (07) 5433 4000

STAGE 19, CAPESTONE AS CONSTRUCTED EARTHWORKS

MBRC SUBDIVISION REFERENCE	
DA/32670/2016/V23R	
No. 1 OF 2 PLANS	
DRAWING NUMBER	REV.
30105-190100 AE	B




LEGEND

8.8 — AS CONSTRUCTED CONTOURS
(Interval 0.2m)

— RETAINING WALL

○ PM55164

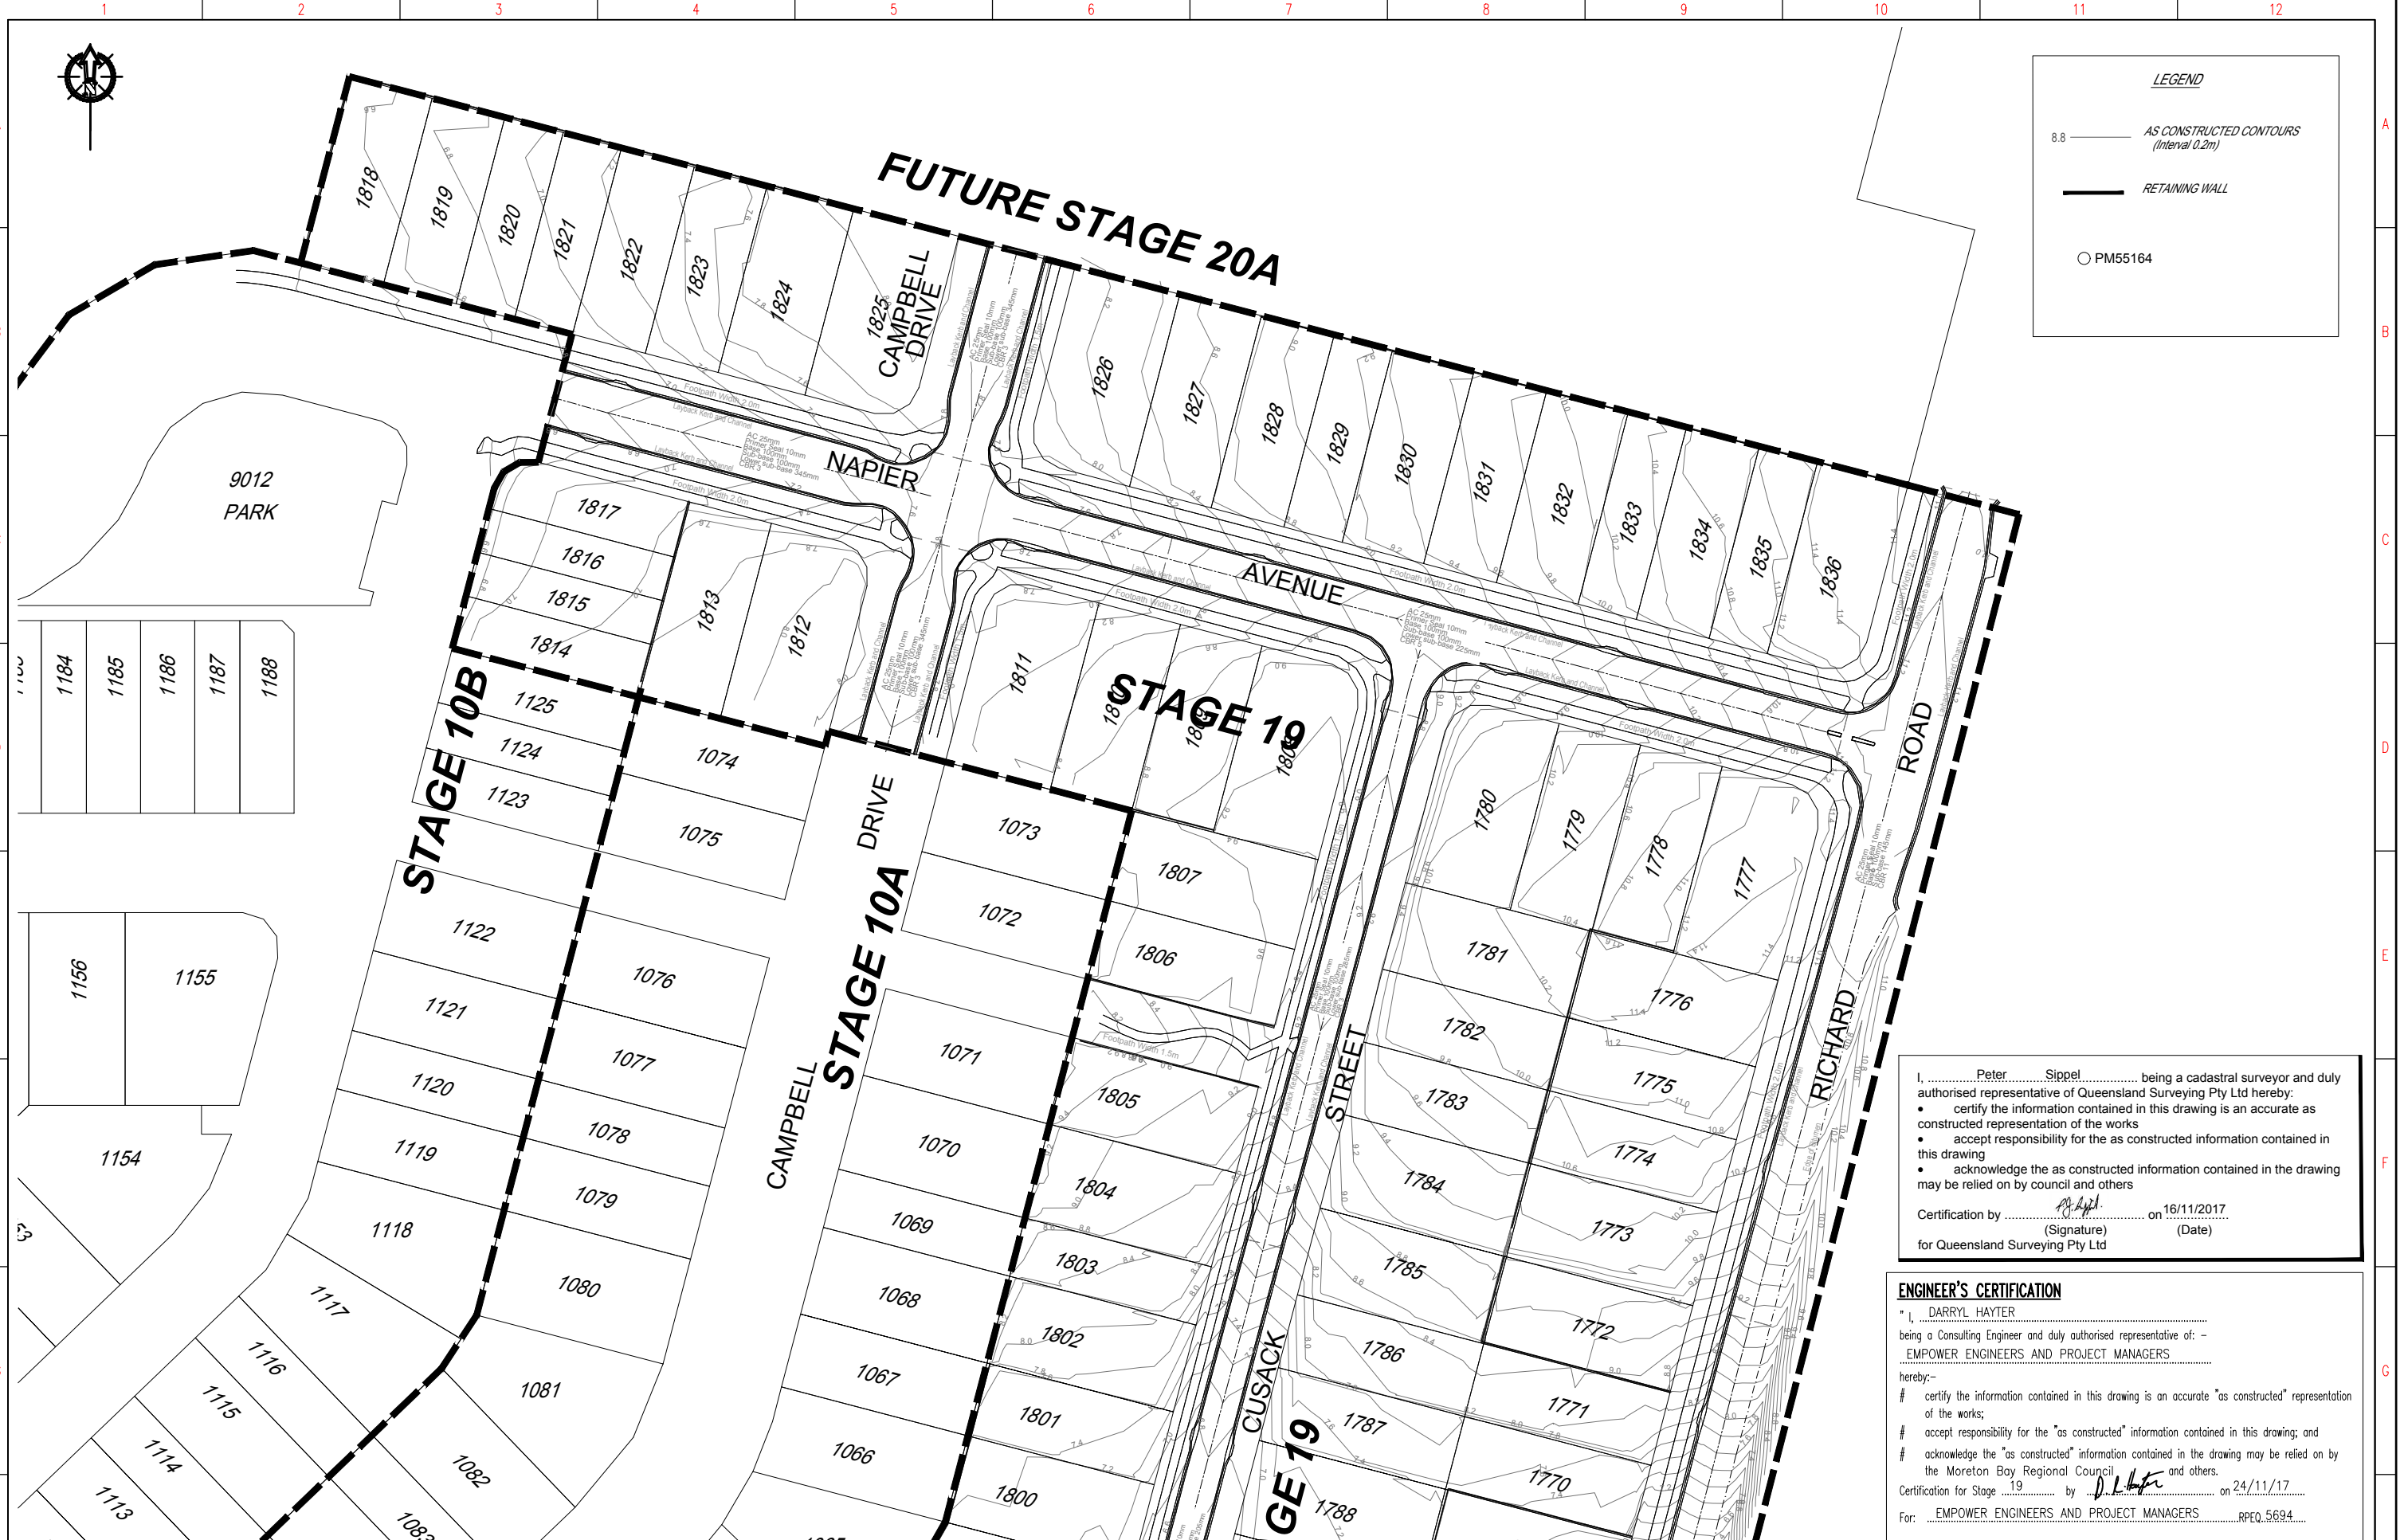

I, Peter Sippel, being a cadastral surveyor and duly authorised representative of Queensland Surveying Pty Ltd hereby:

- certify the information contained in this drawing is an accurate as constructed representation of the works
- accept responsibility for the as constructed information contained in this drawing
- acknowledge the as constructed information contained in the drawing may be relied on by council and others

Certification by *P. Sippel* on 16/11/2017
(Signature) (Date)
for Queensland Surveying Pty Ltd

ENGINEER'S CERTIFICATION

I, DARRYL HAYTER, being a Consulting Engineer and duly authorised representative of: — EMPOWER ENGINEERS AND PROJECT MANAGERS hereby:

- certify the information contained in this drawing is an accurate "as constructed" representation of the works;
- accept responsibility for the "as constructed" information contained in this drawing; and
- acknowledge the "as constructed" information contained in the drawing may be relied on by the Moreton Bay Regional Council and others.

Certification for Stage 19 by *D. Hayter* on 24/11/17
For: EMPOWER ENGINEERS AND PROJECT MANAGERS RPEQ 5694

DRAWING REVISIONS		REFERENCE DRAWINGS		DESIGN FILE No.	DESIGNED
REV.	REVISION DESCRIPTION	DRG. No.	DESCRIPTION	CONSTRUCT. No.	DATE
A	Progress Plot			SURVEY FILE No. 30105-190100 AE	EJM
B	Update			FIELD BOOK	DATE 10/11/2017
				LOG BOOK	CHECKED EJM
				LEVEL DATUM	DATE 10/11/2017
				DATUM	AHD PM177891

THIS WORK WAS PREPARED BY:
QUEENSLAND SURVEYING PTY LTD

SCALE 1:500 ORIGINAL SIZE A1

MORETON BAY REGIONAL COUNCIL
CABOOLTURE DISTRICT OFFICE
2 HASKING STREET CABOOLTURE QLD 4510
PO BOX 159 CABOOLTURE QLD 4510
Telephone: (07) 5433 0100
Fax: (07) 5433 4000

STAGE 19, CAPESTONE AS CONSTRUCTED EARTHWORKS

MBRC SUBDIVISION REFERENCE	
DA/32670/2016/V23R	
No. 2 OF 2 PLANS	
DRAWING NUMBER	REV.
30105-190100 AE	B